

DIGITAL TOPOGRAPHICAL MAP OF MYMENSINGH EN

NAME OF THE CLIENT

Principal, Mymensingh Engineering College

LOCATION OF THE PROJECT

Mymensingh Engineering College
Rahmatpur Bypass Mour
Bypass Road, Mymensingh
GPS Location: 24.781386, 90.344357

DATE OF SUBMISSION

August, 2026

SURVEYED BY




REAL SURVEY INSPECTION

REAL SURVEY INSPECTION

Dhaka Office: House No. 19, Road No. 08, Block- H, Mirpur- 02, Dhaka- 1216
Mobile: 01715118895, 01711388970, E-mail: realsurveyinspection@gmail.com

DIGITAL TOPOGRAPHICAL MAP OF MYMENSINGH ENGINEERING COLLEGE


DIMENSION MAP & ELEVATION MAP

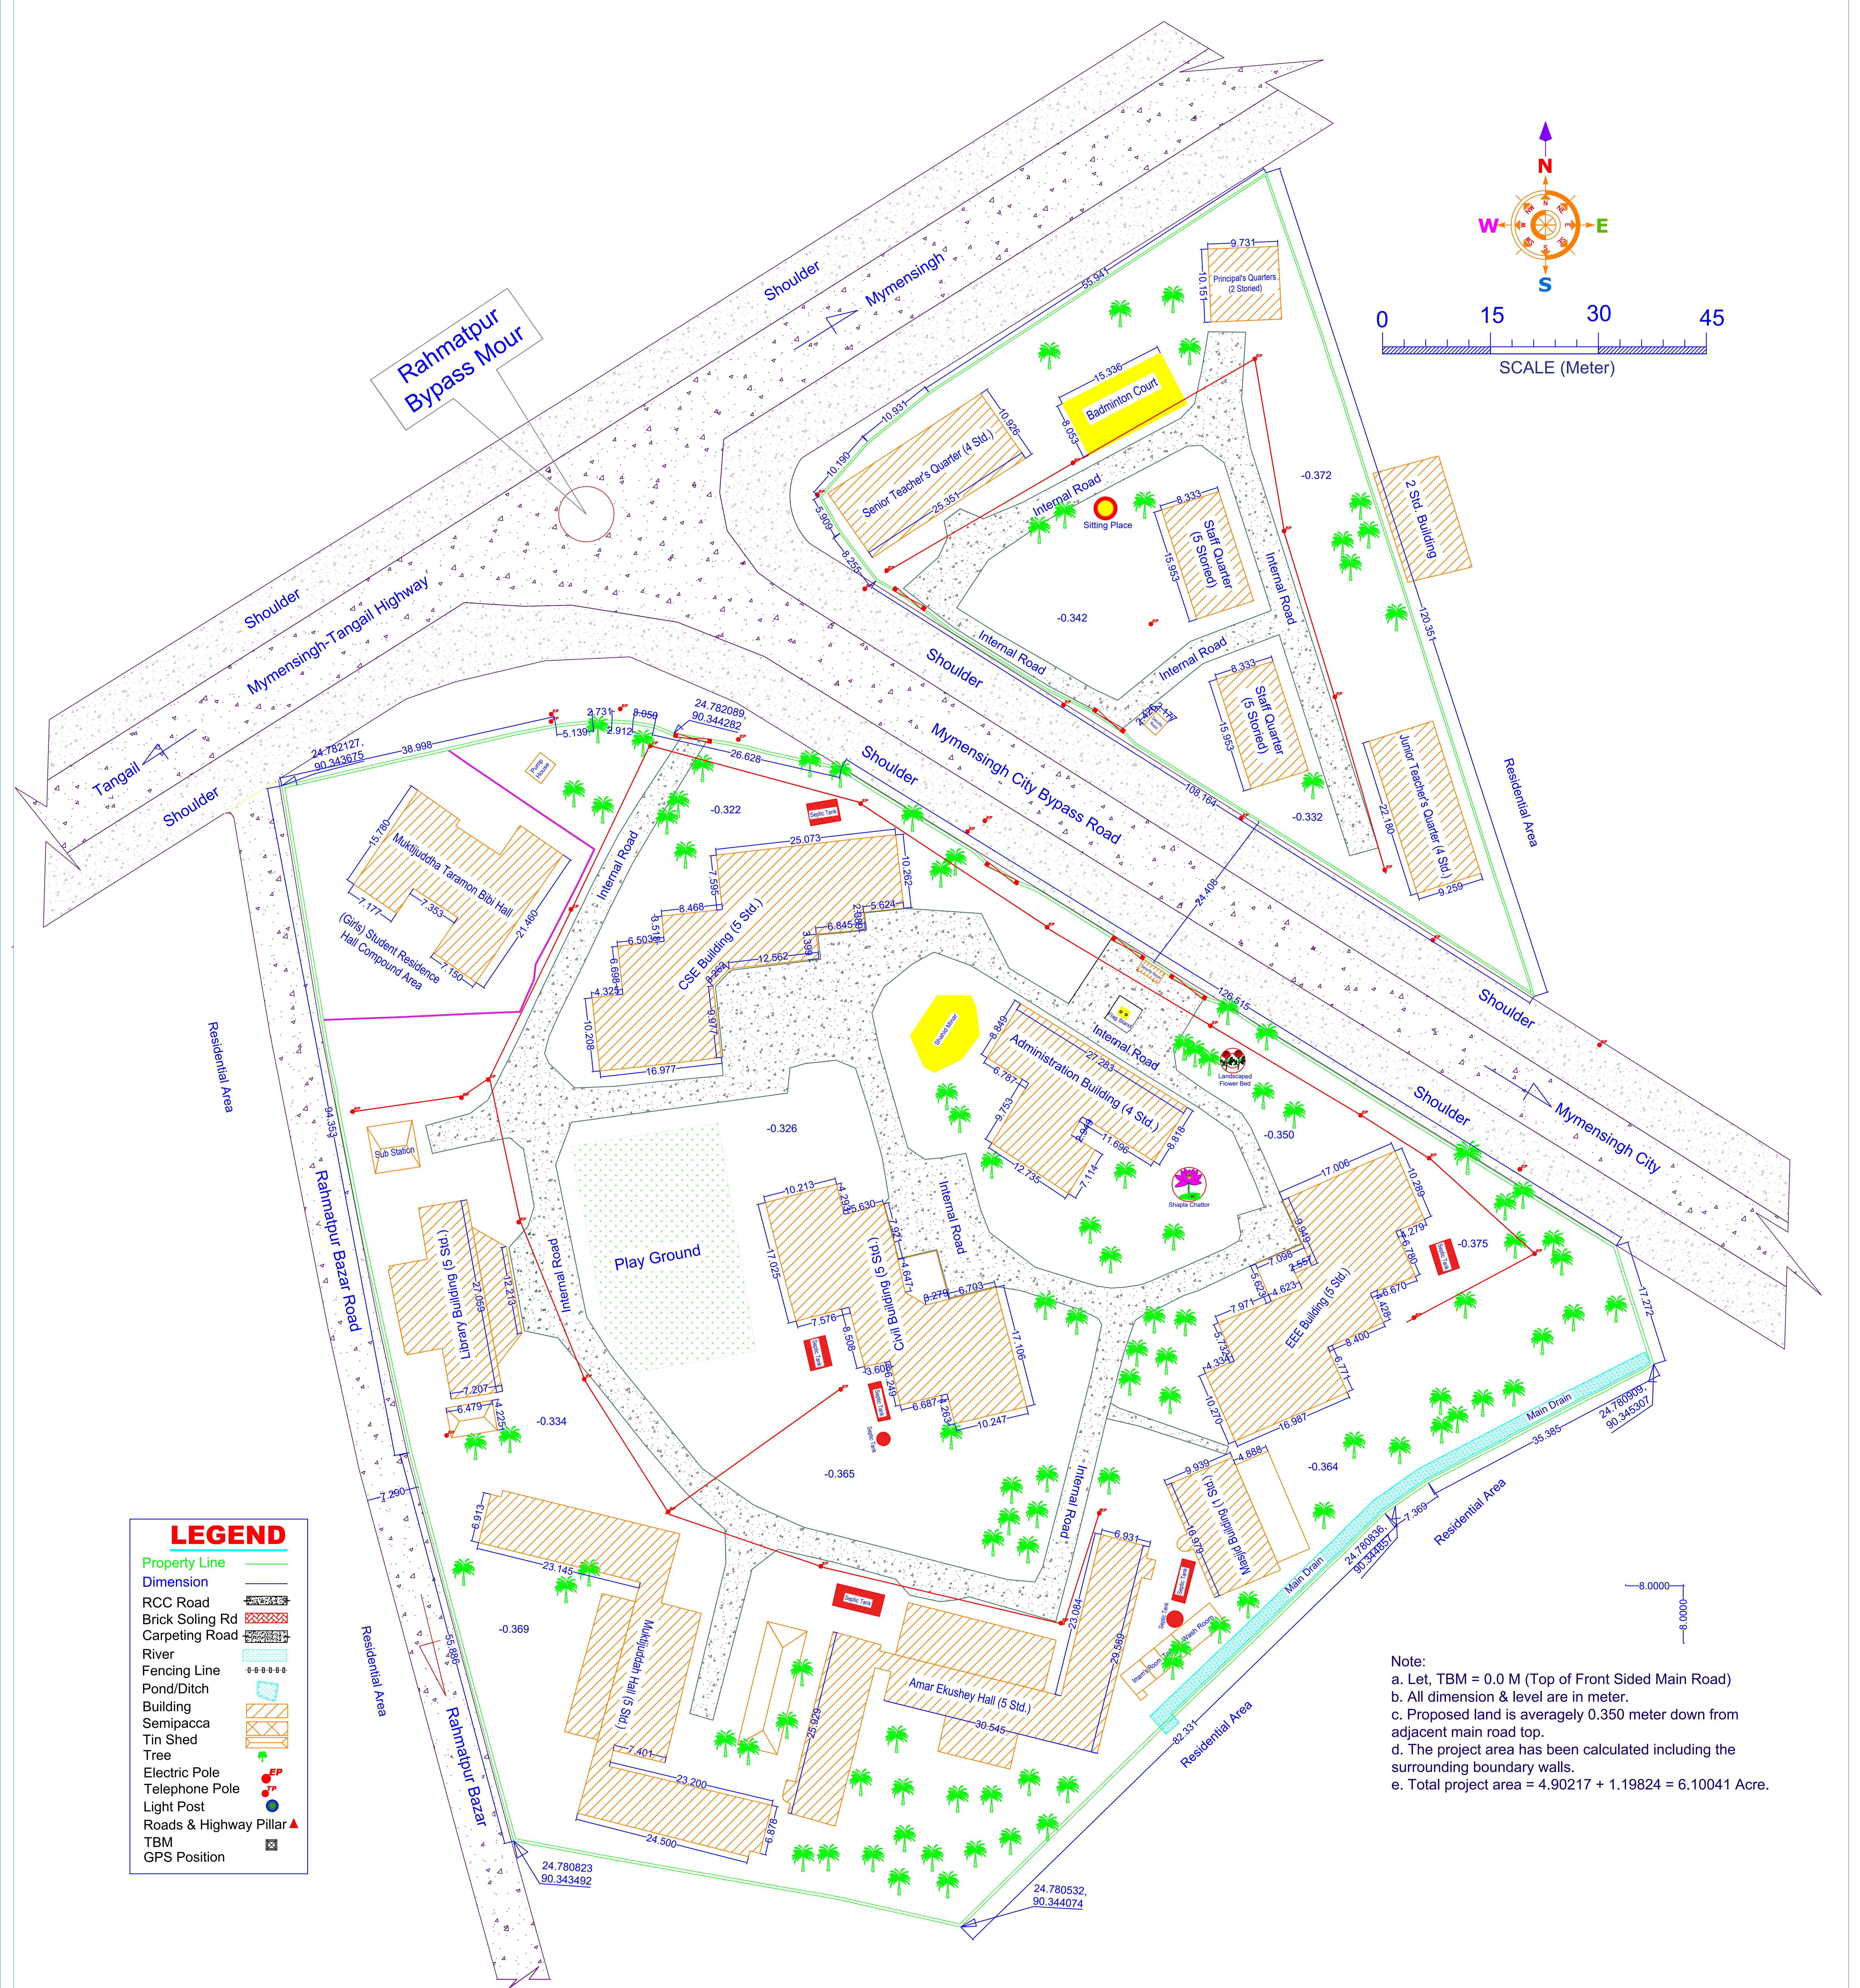

Note:
a. Let, TBM = 0.0 M (Top of Front Sided Main Road)
b. All dimension & level are in meter.
c. Proposed land is averagely 0.350 meter down from adjacent main road top.
d. The project area has been calculated including the surrounding boundary walls.
e. Total project area = 4.90217 + 1.19824 = 6.10041 Acre.

LOCATION OF THE PROJECT	NAME OF THE CLIENT	CHECKED BY	SURVEYED BY	Our Professional Services	DRAWING TITLE	TOTAL PROJECT AREA	"Authorized Signature & Seal"
Mymensingh Engineering College Rahmatpur Bypass Mour Bypass Road, Mymensingh	Mymensingh Engineering College	Arch. Ashiqur Rahman	REAL SURVEY INSPECTION House No. 19, (4th Floor), Road No. 08 Block- H, Mirpur- 02, Dhaka- 1216 Cell: 01715118895, 01711388970 Email: realsurveyinspection@gmail.com Web: www.realsurveyinspection.com	All Kinds of Land Digital Survey, Contour Survey, Digital Geo-Referencing & KML Mapping, Mouza Map Geo-Referencing with Google Earth (KML), Mouza Map Geo-Referencing with Google Earth (KMZ), Hydrographic Survey, Layout, Plotting, Earth Volume Calculation, Mouza Map Digitalization, Pantograph, As Built Plan, Flat /Floor Measurement, GPS Survey, Land and properties valuation survey, And Geo-technical Investigations (Soil Test)	Details Map	= 213,538.583 Sft. = 490.217 Decimal = 4.90217 Acre & Perimeter = 562.1505 M = 52,195.768 Sft. = 119.824 Decimal = 1.19824 Acre & Perimeter = 319.877 M	
		DATE OF SUBMISSION			SHEET NO.		
		July- 2026			02 of 03		
		SURVEYED BY			Ref. No.		
	Sajib Hossain Diploma in Surveying	DRAWING BY	Mukul Cahandra Ray B. Sc. in Civil		559-A		

DIGITAL TOPOGRAPHICAL MAP OF MYMENSINGH ENGINEERING COLLEGE
DETAILS MAP (GPS Co-ORDINATE, SURROUNDINGS, STRUCTURE ETC.)

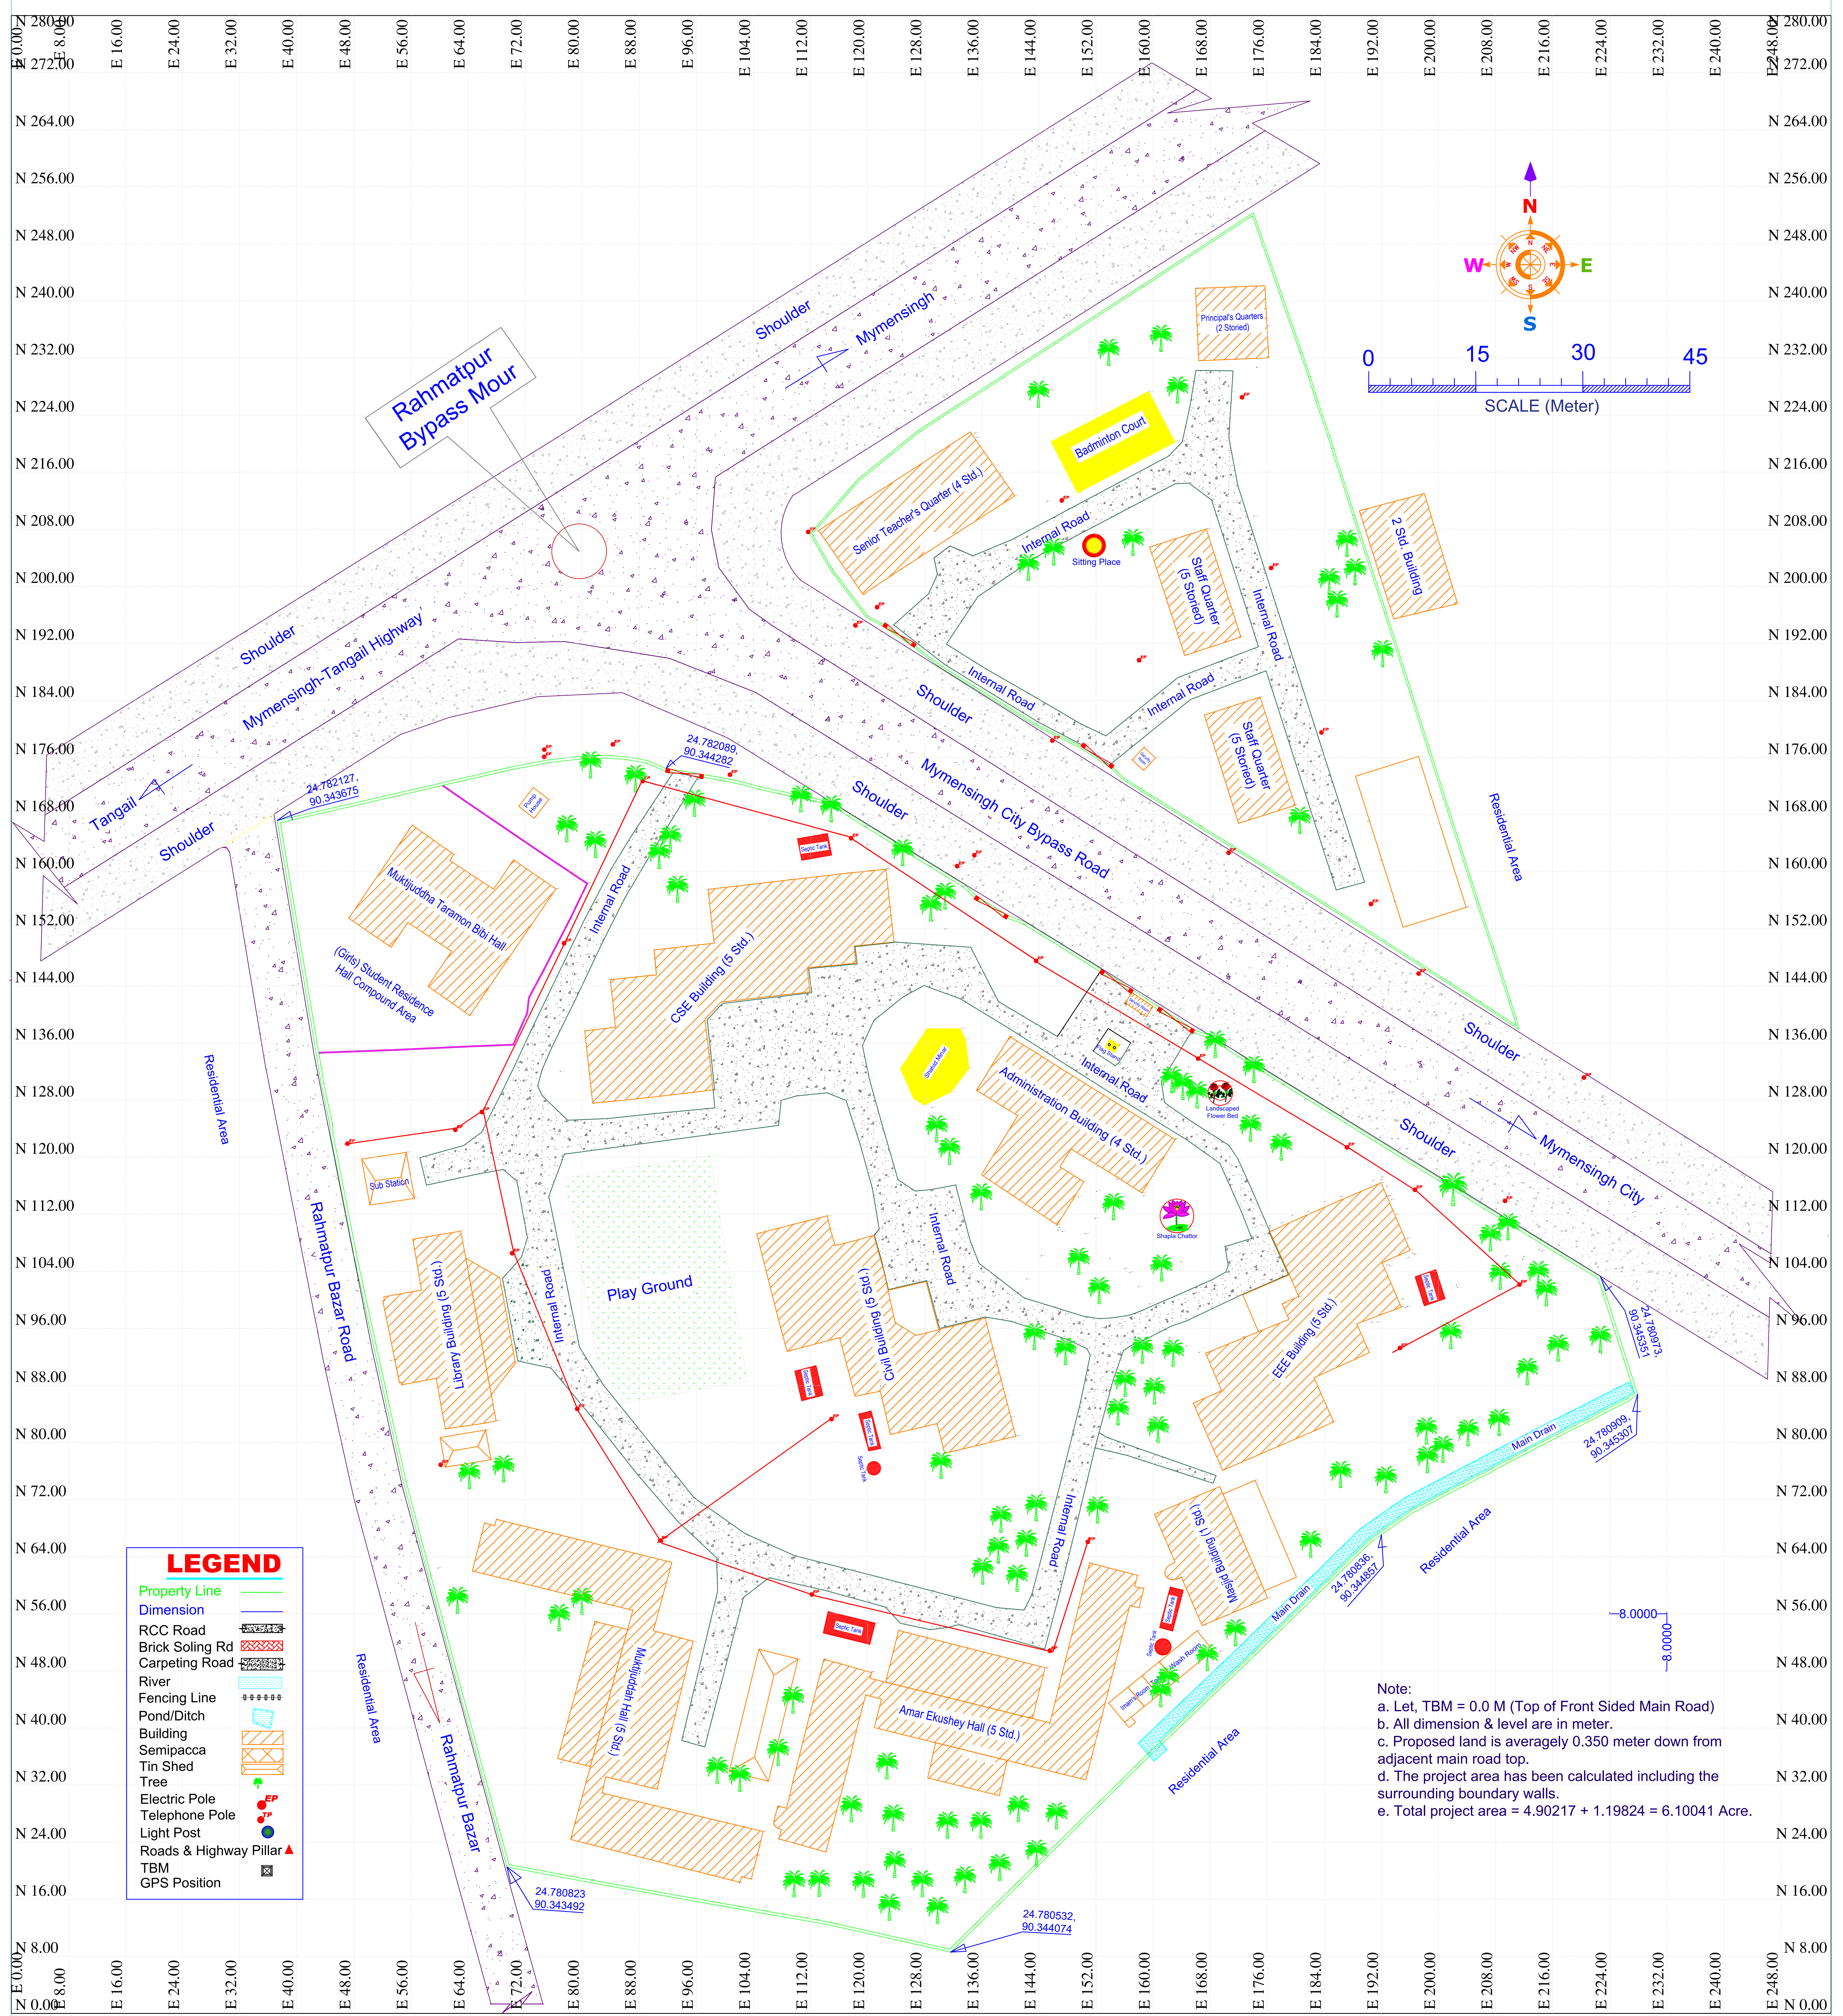

Note:
a. Let, TBM = 0.0 M (Top of Front Sided Main Road)
b. All dimension & level are in meter.
c. Proposed land is averagely 0.350 meter down from adjacent main road top.
d. The project area has been calculated including the surrounding boundary walls.
e. Total project area = 4.90217 + 1.19824 = 6.10041 Acre.

LOCATION OF THE PROJECT	NAME OF THE CLIENT	CHECKED BY	SURVEYED BY	Our Professional Services	DRAWING TITLE	TOTAL PROJECT AREA	"Authorized Signature & Seal"
Mymensingh Engineering College Rahmatpur Bypass Mour Bypass Road, Mymensingh	Mymensingh Engineering College	Arch. Ashiqur Rahman	 REAL SURVEY INSPECTION House No. 19, (4th Floor), Road No. 08 Block- H, Mirpur- 02, Dhaka- 1216 Cell: 01715118895, 01711388970 Email: realsurveyinspection@gmail.com Web: www.realsurveyinspection.com PRECISION FIRST	Alll Kinds of Land Digital Survey, Contour Survey, Digital Geo-Referencing & KML Mapping, Mouza Map Geo-Referencing with Google Earth (KML), Mouza Map Geo-Referencing with Google Earth (KMZ), Hydrographic Survey, Layout, Plotting, Earth Volume Calculation, Mouza Map Digitalization, Pantograph, As Built Plan, Flat /Floor Measurement, GPS Survey, Land and properties valuation survey, And Geo-technical Investigations (Soil Test)	Details Map	= 213,538.583 Sft. = 490.217 Decimal = 4.90217 Acre & Perimeter = 562.1505 M = 52,195.768 Sft. = 119.824 Decimal = 1.19824 Acre & Perimeter = 319.877 M	
		DATE OF SUBMISSION			SHEET NO.		
		July- 2026			03 of 03		
		SURVEYED BY Sajib Hossain Diploma in Surveying			Ref. No. 559-A		
		DRAWING BY Mukul Cahandra Ray B. Sc. in Civil					